



140 John James Audubon Parkway, Suite 201, Amherst, New York 14228
P 716.688.0766 F 716.625.6825

ADDENDUM NO. 1

Cattaraugus County
Little Valley County Center Court Renovations – Second Floor
Little Valley, NY

DATE

July 29, 2013

OWNER

Cattaraugus County
303 Court Street
Little Valley, New York 14755

ARCHITECT/ENGINEER

Wendel
140 John James Audubon Parkway
Suite 201
Amherst, NY 14228
Phone: 716-688-0766
Fax: 716-625-6825

Project No. 307635

This Addendum is being issued to clarify the bid documents and shall supersede and supplement all portions of previously issued bid documents with which it conflicts. It shall be made an integral part of the construction documents.



140 John James Audubon Parkway, Suite 201, Amherst, New York 14228
P 716.688.0766 F 716.625.6825

Project Cattaraugus County Little Valley County Center Addendum No. 1
Court Renovations – Second Floor Contract _____
Wendel Project No. 307635 Date 7/29/13

ARTICLE - 1 DRAWING NO. _____
SPEC SECTION General

ADD: Pre-Bid meeting minutes and sign in sheet, attached as part of this addendum.

ARTICLE - 2 DRAWING NO. _____
SPEC SECTION Section A

DELETE: Section A in its entirety.

ARTICLE - 3 DRAWING NO. _____
SPEC SECTION Section B

DELETE: Pages B1 and B2.

ADD: New pages B-1, B-2, B-2.1 and B-2.2, attached as part of this addendum.

ARTICLE - 4 DRAWING NO. _____
SPEC SECTION 011000

ADD: Para 1.7.A.3

3. Maintain owner access to Existing Vault 207 and File Room adjacent to the east of Existing Surrogate Office 206 throughout the time of demolition and construction activities. Notify the owner prior to any times that access must be restricted and restrict any non-access time to no more than three working days.



140 John James Audubon Parkway, Suite 201, Amherst, New York 14228
P 716.688.0766 F 716.625.6825

Project Cattaraugus County Little Valley County Center Addendum No. 1
Court Renovations – Second Floor Contract _____
Wendel Project No. 307635 Date 7/29/13

ARTICLE - 5 DRAWING NO. _____
SPEC _____
SECTION 028214

REPLACE: First sentence of Summary 1.2 A to read as follows:

“This project consists of the removal of asbestos materials from Cattaraugus County Court building located at the Little Valley County Center located at 303 Court Street in Little Valley, New York.”

REPLACE: Section 1.3 F “Scope of Work” with the following:

- F. The contractor shall furnish all labor, materials, services, employee training, permits, notifications insurance and equipment to remove the following asbestos containing materials from the areas indicated on contract drawings:
1. Remove and properly dispose of asbestos containing mud joint/fitting insulation in the areas indicated. Coordinate removals with plumbing drawings to accommodate existing plumbing removals and tie-ins of new plumbing. Removals to accommodate proposed tie-ins may exist above first floor ceiling. Any fittings that require abatement outside the area shown on the drawing are the responsibility of the abatement contractor under this contract. Demolition of walls and ceilings required to access asbestos containing materials shall be conducted by a licensed asbestos abatement contractor as per 12NYCRR56-7.11(F)(4). Area containment measures and removal shall be in compliance with 12NYCRR56.
 2. Remove and properly dispose of existing flooring system in its entirety to bare concrete substrate. Floor tile mastic is an asbestos-containing material. Removal shall include all carpet and underlying floor tile and mastic, as well as any flooring materials beneath walls and/or millwork that are scheduled for demolition. See A100 for locations of transition strips indicating termination of removal. Area containment measures and removal shall be in compliance with 12NYCRR56.
 3. Remove and properly dispose of ceramic floor tile and associated mudset and grout in its entirety. Mudset and grout of ceramic floor tile has been assumed to be an asbestos-containing material. Area containment measures and removal shall be in compliance with 12NYCRR56.

ARTICLE - 6 DRAWING NO. A100
SPEC _____
SECTION _____

ADD: Temporary construction partition in room 205 and 206 during construction to allow owners staff to access Vault and Records room. Size and requirements as indicated on attached drawing SD-A03 and SD-A04.

REVISE: Furring dimensions at west end of new counter as indicated on attached drawing SD-A01.



140 John James Audubon Parkway, Suite 201, Amherst, New York 14228
P 716.688.0766 F 716.625.6825

Project Cattaraugus County Little Valley County Center Addendum No. 1
Court Renovations – Second Floor Contract _____
Wendel Project No. 307635 Date 7/29/13

ARTICLE - 7 DRAWING NO. A101
SPEC
SECTION _____

ADD: Existing floor to floor building section for reference as indicated on attached drawing SD-A05.

ARTICLE - 8 DRAWING NO. A102
SPEC
SECTION _____

REVISE: Soffit dimensions at west end of counter as indicated on attached drawing SD-A02.

ARTICLE - 9 DRAWING NO. HMA100
SPEC
SECTION _____

ADD: Additional areas of floor tile to be abated including Surrogate General Office 206, Waiting area 205 and hallway leading to Surrogate Chief Clerk 202 as indicated on attached drawing SD-HM01.

REPLACE: General Drawing Notes and Asbestos Removal Notes as indicated on attached drawing SD-HM02.

ARTICLE - 10 DRAWING NO. ED100
SPEC
SECTION _____

REVISE: Drawing ED100 as shown on sketch SD-E01 issued as part of this addendum.

ARTICLE - 11 DRAWING NO. E101
SPEC
SECTION _____

REVISE: Drawing E101 as shown on sketch SD-E02 issued as part of this addendum.



140 John James Audubon Parkway, Suite 201, Amherst, New York 14228
P 716.688.0766 F 716.625.6825

Project	<u>Cattaraugus County Little Valley County Center</u>	Addendum No.	<u>1</u>
	<u>Court Renovations – Second Floor</u>	Contract	<u></u>
Wendel Project No.	<u>307635</u>	Date	<u>7/29/13</u>

ARTICLE -	<u>12</u>	DRAWING NO.	<u>E102</u>
		SPEC	<u></u>
		SECTION	<u></u>

REVISE: Drawing E102 as shown on sketch SD-E03 issued as part of this addendum.



PRE BID MEETING MINUTES

140 John James Audubon Parkway, Suite 201
Amherst, NY 14228

Phone: 716-688-0766
Fax: 716-625-6825

No. 001
Project No. 307635

Project Title: 2nd Floor Court Renovations
Cattaraugus DPW Bid No. 48
Location: 303 Court St Little Valley, NY 14755
- 3rd Floor Majority Room
Meeting Date: 07/22/13
Subject: Pre-Bid Meeting

Attendees: See attached sign in sheet.

Item	Ball in Court	Description	Status	Started	Due
1		Introductions were made by all in attendance	-	-	-
2		Project Bidding – Bids due on August 2, 2013 by 1:45pm to be publicly opened at 2:00pm.	-	-	-
3		Addendum will be issued July 29, 2013.	-	-	-
4		Project work Scope was discussed	-	-	-
5		Bid Requirements – Bidders were reminded that it a general contractor bid. The bid form and Wicks reform subcontractor information will be revised and included in the forthcoming addendum.	-	-	-
6		Clarification of flooring removal at existing room 206 to be clarified in the addendum.			
7		Existing temperature controls shall be relocated per the plans, and not updated.			
8		Existing light fixtures at room 202 shall be removed and not used.			
9		A walk-through of Project Area at each floor was conducted.	-	-	-

The above minutes represent Wendel's understanding of the major topics discussed. Please provide any additions/deletions to the undersigned within 5 business days of receipt.

Prepared By: Wendel

Signed: Joseph Kedron; AIA

Dated: 07/23/13



Pre-Bid Meeting Sign In Sheet

Page 1 of 5

Project No.: 3076-35

Date: July 22, 2013

Project Name: 2nd Floor Court Office Renovation

	Company Name & Address	Names of Attendendeas (Please Print)	Phone Number	Fax Number and e-mail address
1	Catt Co. DPW	Laura Livermore	938-2465	938-2782 ljlivermore@cattco.org
2	Catt. Co. DPW Commissioner	Joe Pillittere	938-2483	938-2753 jtpillittere@cattco-nc
3	WENDEL	JOE KEDRON	688-0766	JKEDRON@WP-AE.COM
4	St. John Building of WNY, Inc.	Katie Ambuski Mike St. John	945-2683	sales@stjohn building.com
5	E.E. AUSTIN	DUSTIN DAMCOTT	665.3316	665.5382 ddamcott@eeaustin.com
6	MAZZA MECHANICAL SERVICES	John Finson	372.0091	jfinson@mazza-hvac.com 373.6021
7	Kinley Corporation PO Box 1190 Olean, NY 14760	BEN HECKATHORN	716-372-4534	716-372-0820 Ben.Heckathorn@kinleycorp.com



Pre-Bid Meeting Sign In Sheet

Page 2 of 5

Project No.: 3076-35

Date: July 22, 2013

Project Name: 2nd Floor Court Office Renovation

	Company Name & Address	Names of Attendendees (Please Print)	Phone Number	Fax Number and e-mail address
8	Ahlstrom Schaeffler Elec 46 Hopkins Ave Jamestown, NY 14701	Jim McIntyre	716 665 6510	(716) 665-5246 jmcintyre @ as-elec.com
9	BECC ELECTRIC 1607 CENTRAL AVE DUNKIRK, NY 14048	BENNY BUTTITA JR	716-363-7602	716-366-9528 BENNY @ BECC ELECTRIC CORP
10	HA H&K Services 12025 Leon Rd, (Rt. 6) Leon, NY 14751	Bill Hirschman	716-296-5290	716-296-8142 b.hirschman@h-k-services.com
11	Duggan + Duggan GC Inc P.O. Box 5 Allegany, NY 14706	Kyle Duggan	716 373-1033	716-373-1122 kyle@duggan-duggan.com
12	Clarence Wall and Ceiling Inc 9393 Main St. Clarence NY 14755	Troy Stalica	716-759-2944 ext 103	716-759-2886 TStalica @ clarencewall.com



Pre-Bid Meeting Sign In Sheet

Page 3 of 5

Project No.: 3076-35

Date: July 22, 2013

Project Name: 2nd Floor Court Office Renovation

Company Name & Address		Names of Attendees (Please Print)	Phone Number	Fax Number and e-mail address
13	KIRST CONSTRUCTION N. Boston NY	DON KIRST	716 649 0906	649 0206 donaldkirst@yahoo.com
14	STOHL REMEDIATION SERVICES 4169 ALLENDALE PKWY BLASDELL, NY 14219	PAUL GIZZARELLI	716-312-0070	716-312-8092 paul@stohlenv.com
15	ARRIC CORP 5033 RAUSCH RD Depew NY 14043	PAUL KELLER	716-681-3535	716-681-5889 ARRICCORP@AOL.COM
16				
17				
18				
19				

Cattaraugus County
Court Renovations - Second Floor
Little Valley County Center
Wendel Project No. 307635

**BID FORM
GENERAL CONSTRUCTION**

To: John Searles
Cattaraugus County
303 Court Street
Little Valley, New York 14755

In compliance with your Advertisement for Bids, the undersigned:

(Name of firm, partnership or Corporation)

hereby proposes to furnish all supervision, labor, materials, plant, tools, equipment, transportation, overhead and profit, and other facilities related to, proper for, or incidental to the Boiler Replacement at the Little Valley County Center, Little Valley, New York, in strict accordance with the Project Manual dated March 27, 2013, and the Drawings mentioned therein, and including any subsequently issued addenda for consideration of the following Lump Sum amount:

BASE BID:

_____ Dollars (\$_____)

BID BREAKDOWN: Submit with this bid a separate sealed list, using subcontractor information(SCI) form, that names each (the) subcontractor that the bidder will use to perform the work on the contract, and the agreed upon amount to be paid.

After the low bid is announced, the sealed list submitted with the low bid will be opened and the names of the subcontractor(s) announced. The sealed lists submitted by all other bidders will be returned unopened after the award of the contract.

PROPOSED EQUIVALENTS

The Contractor has included in the Base Bid the following kinds, types, brands, or manufacturers of materials in lieu of those named in the specifications. The Contractor understands that he includes these proposed equivalent items in the Base Bid at his own risk, as they are subject to the approval of the Architect. The Contractor certifies that the following constitute the extent of proposed equivalent items included in the Base Bid and that the remainder of kinds, types, brands, or manufacturers included in the Base Bid are those named in the specifications.

<u>ITEM</u>	<u>SPECIFICATION SECTION & PARAGRAPH(S)</u>	<u>PROPOSED EQUIVALENT</u>
_____	_____	_____
_____	_____	_____
Cattaraugus County
Court Renovations - Second Floor
Little Valley County Center
Wendel Project No. 307635

ATTACH ADDITIONAL PROPOSED EQUIVALENT ITEMS TO BID FORM.

The Bidder agrees that this Proposal shall be good and may not be withdrawn for a period of forty-five (45) calendar days from the date of Bid opening. Furthermore, the undersigned will, within ten (10) days of written notice of acceptance of this bid, execute a contract in the form specified and submit specified Performance and Payment Bonds.

The Bidder understands that the Owner specifically reserves the right to reject any and all Bids and to waive any informality therein.

The undersigned agrees to complete the work in accordance with the time period specified in the Supplementary Instructions to Bidders.

Addendum Receipt: The receipt of the following addenda to the Specifications is acknowledged:

Addendum No. _____	Date _____	Addendum No. _____	Date _____
Addendum No. _____	Date _____	Addendum No. _____	Date _____
Addendum No. _____	Date _____	Addendum No. _____	Date _____

Submittals as required by the Instructions/Supplementary Instructions to Bidders, shall be completed and delivered to the Architect, by the two (2) low bidders, within three (3) working days after the Bid opening.

Dated _____, 20____

(Sign Bid Here) By:

Legal Business Address:

Legal name of person, partnership or corporation

Name and Title

Street

City and State

Phone Number

2008 WICKS REFORM – SUBCONTRACTOR INFORMATION

Pursuant to the 2008 Wicks Law Reform, _____
(Company Name of Bidder)
submits with our bid the following sub-contractor(s) and the agreed upon amounts for

Project No. _____ Bid No. 48
Titled 2nd Floor Court Renovations Little Valley, 303 Court Street, Little Valley, NY

Trade: Plumbing and Gas Fitting

<i>Name and Address of Subcontractor</i>	<u>Amount</u>
1. _____ <i>Description of work:</i> _____	_____

Trade: Steam Heating, Hot Water Heating, Ventilating and Air Conditioning Apparatus

<i>Name and Address of Subcontractor</i>	<u>Amount</u>
1. _____ <i>Description of work:</i> _____	_____

Trade: Electric Wiring and Standard Illuminating Fixtures

<i>Name and Address of Subcontractor</i>	<u>Amount</u>
1. _____ <i>Description of work:</i> _____	_____

Dated ____/____/____

Legal name of person, partnership, joint venture or corporation:

(if corporation, affix
corporate seal)

By _____
(Signature)

Title _____

SEAL IN SEPARATE ENVELOPE AND SUBMIT ALONG WITH PROPOSAL

2008 WICKS REFORM – SUBCONTRACTOR INFORMATION
ACKNOWLEDGMENT FOR SUBCONTRACTOR INFORMATION

THE LEGAL ADDRESS OF THE BIDDER

Telephone No. _____ Facsimile No. _____

If a Corporation

Name	Address
_____	President _____
_____	Secretary _____
_____	Treasurer _____

If a Partnership


Name of Partners	Address
_____	_____
_____	_____
_____	_____

If a Joint Venture

Name of Members	Address
_____	_____
_____	_____
_____	_____

If an Individual

Name of Individual	Address
_____	_____
_____	_____
_____	_____

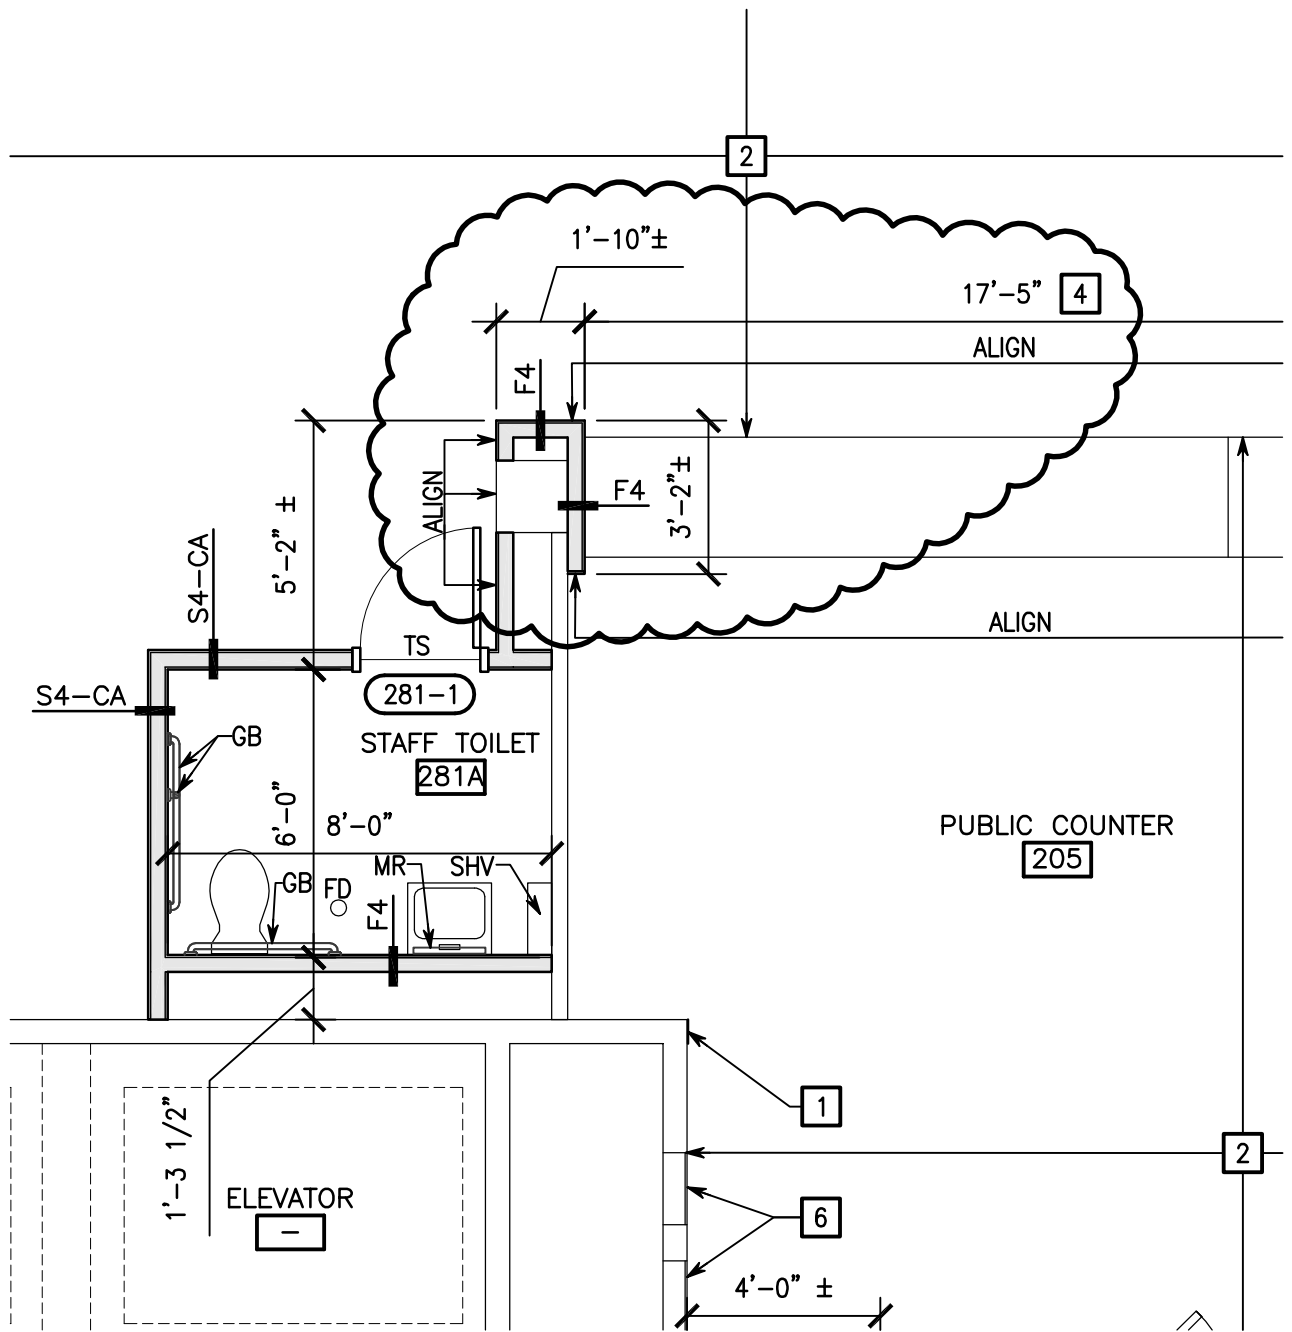

2 PROPOSED PARTIAL SECOND FLOOR PLAN

SCALE: 1/4"=1'-0"



www.wendelcompanies.com

CATTARAUGUS COUNTY
COURT RENOVATIONS ON SECOND FLOOR
LITTLE VALLEY COUNTY CENTER


REVISED FURRING AROUND COLUMN AT
PUBLIC COUNTER

Proj. No. 3076-35


Date 29 JULY 2013

Ref. Dwg. A100

No. SD-A01

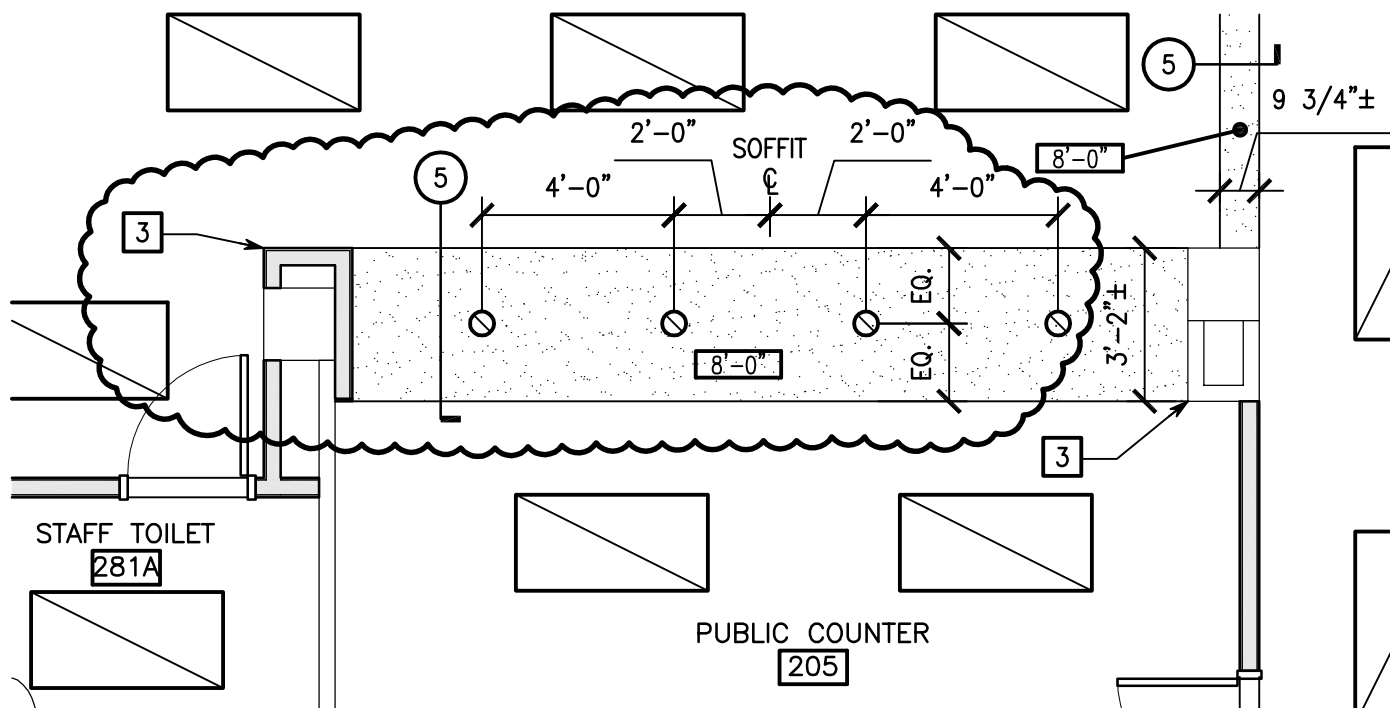


1 **PROPOSED PARTIAL SECOND FLOOR PLAN** SCALE: 1/4"=1'-0"

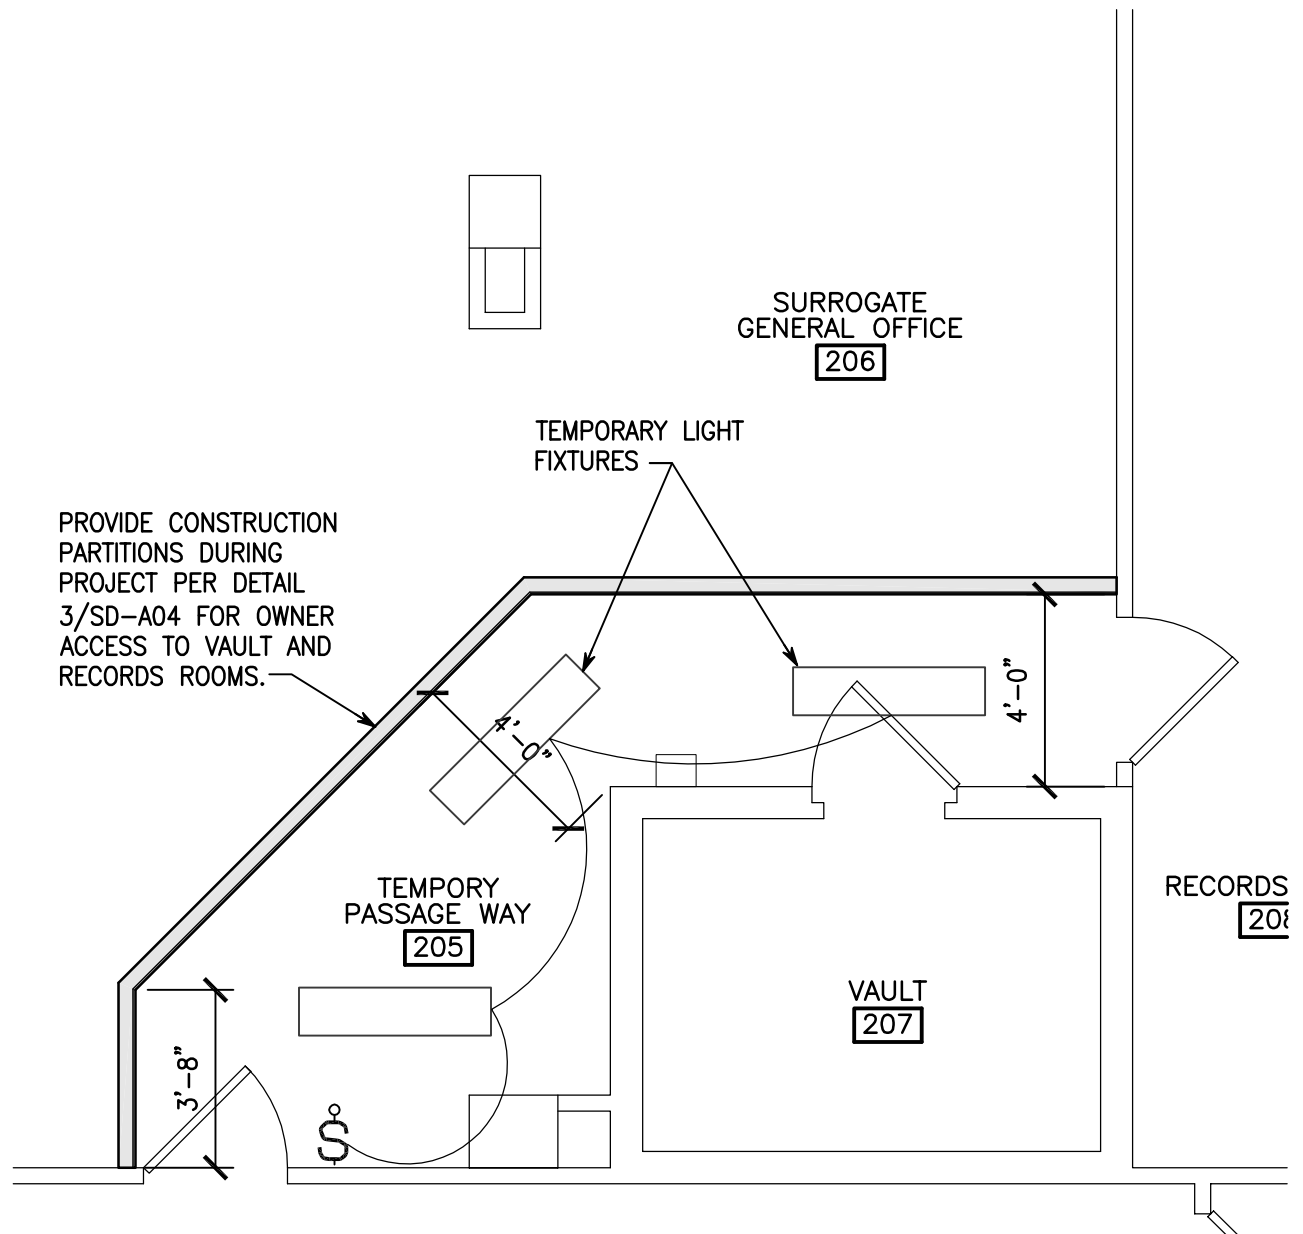

LIGHTING NOTES:

PROVIDE TEMPORARY LIGHTING BY REUSING 1'X4' SURFACE MOUNTED FIXTURES FROM ROOM 202.
 PROVIDE TEMPORARY CONNECTION TO LIGHT CIRCUIT AND PROVIDE NEW TEMPORARY WALL SWITCH TO THESE FIXTURES.
 PROVIDE ALL NECESSARY EMERGENCY LIGHTING TO TEMPORARY PASSAGE WAY.

1 PARTIAL SECOND FLOOR PLAN
 SCALE: 1/4"=1'-0"

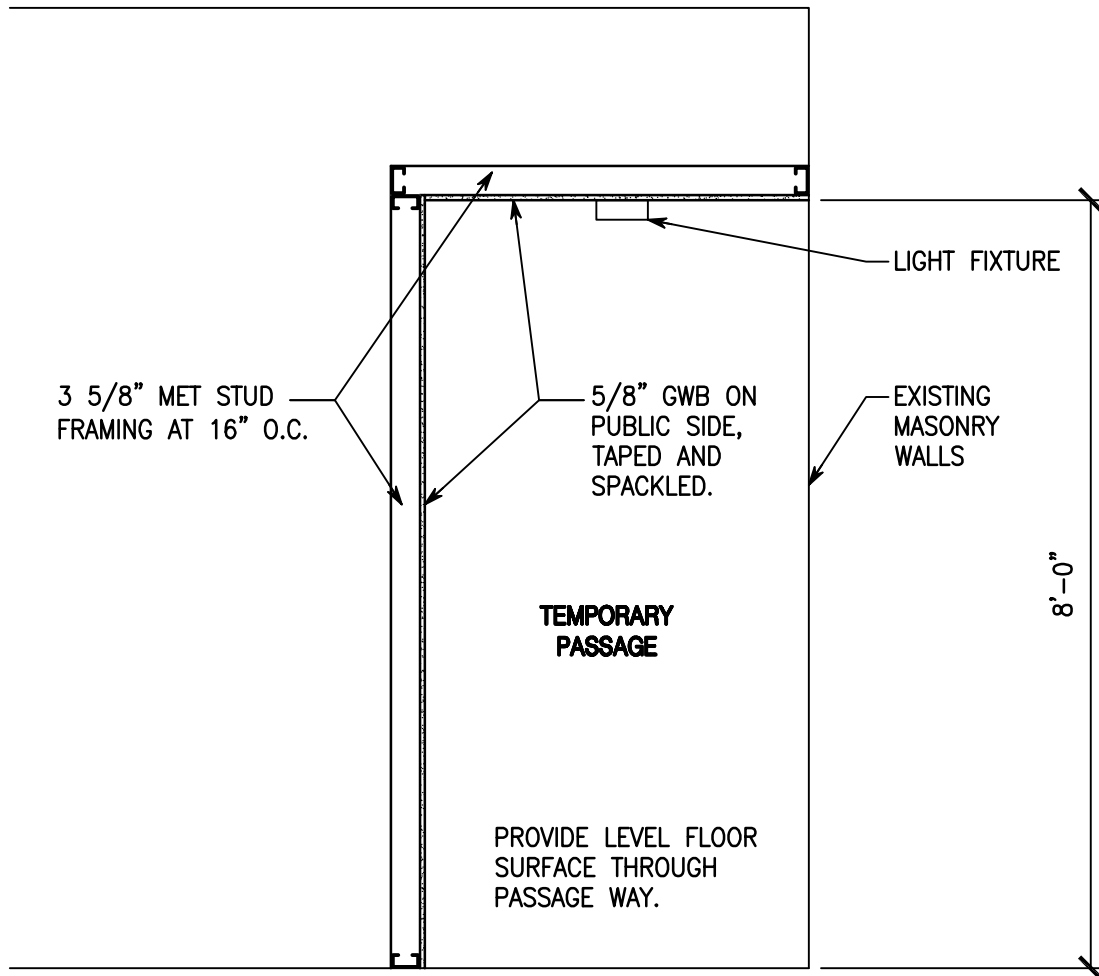

3

CONSTRUCTION PARTITION

SCALE: 1/2"=1'-0"



www.wendelcompanies.com

CATTARAUGUS COUNTY
COURT RENOVATIONS ON SECOND FLOOR
LITTLE VALLEY COUNTY CENTER


TEMPORARY CONSTRUCTION PARTITIONS

Proj. No. 3076-35

Date 29 JULY 2013

Ref. Dwg. A100

No. SD-A04

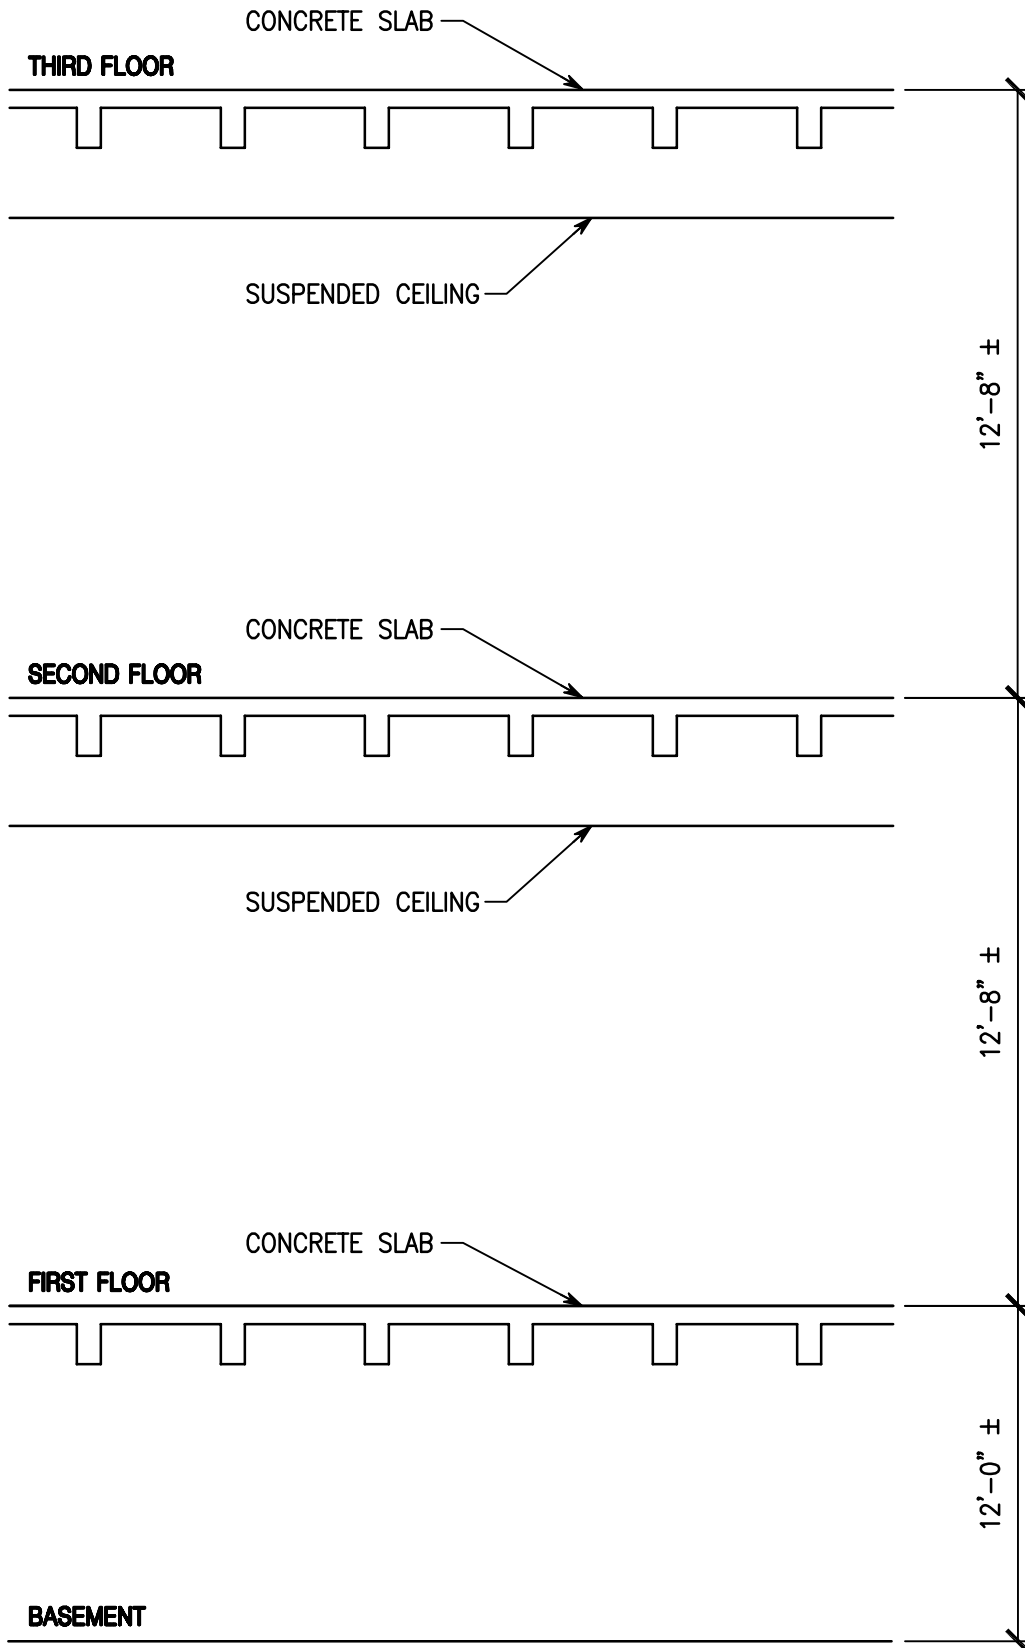

www.wendelcompanies.com

CATTARAUGUS COUNTY
COURT RENOVATIONS ON SECOND FLOOR
LITTLE VALLEY COUNTY CENTER


EXISTING FLOOR TO FLOOR SECTION

Proj. No. 3076-35

Date 29 JULY 2013

Ref. Dwg. A101

No. SD-A05

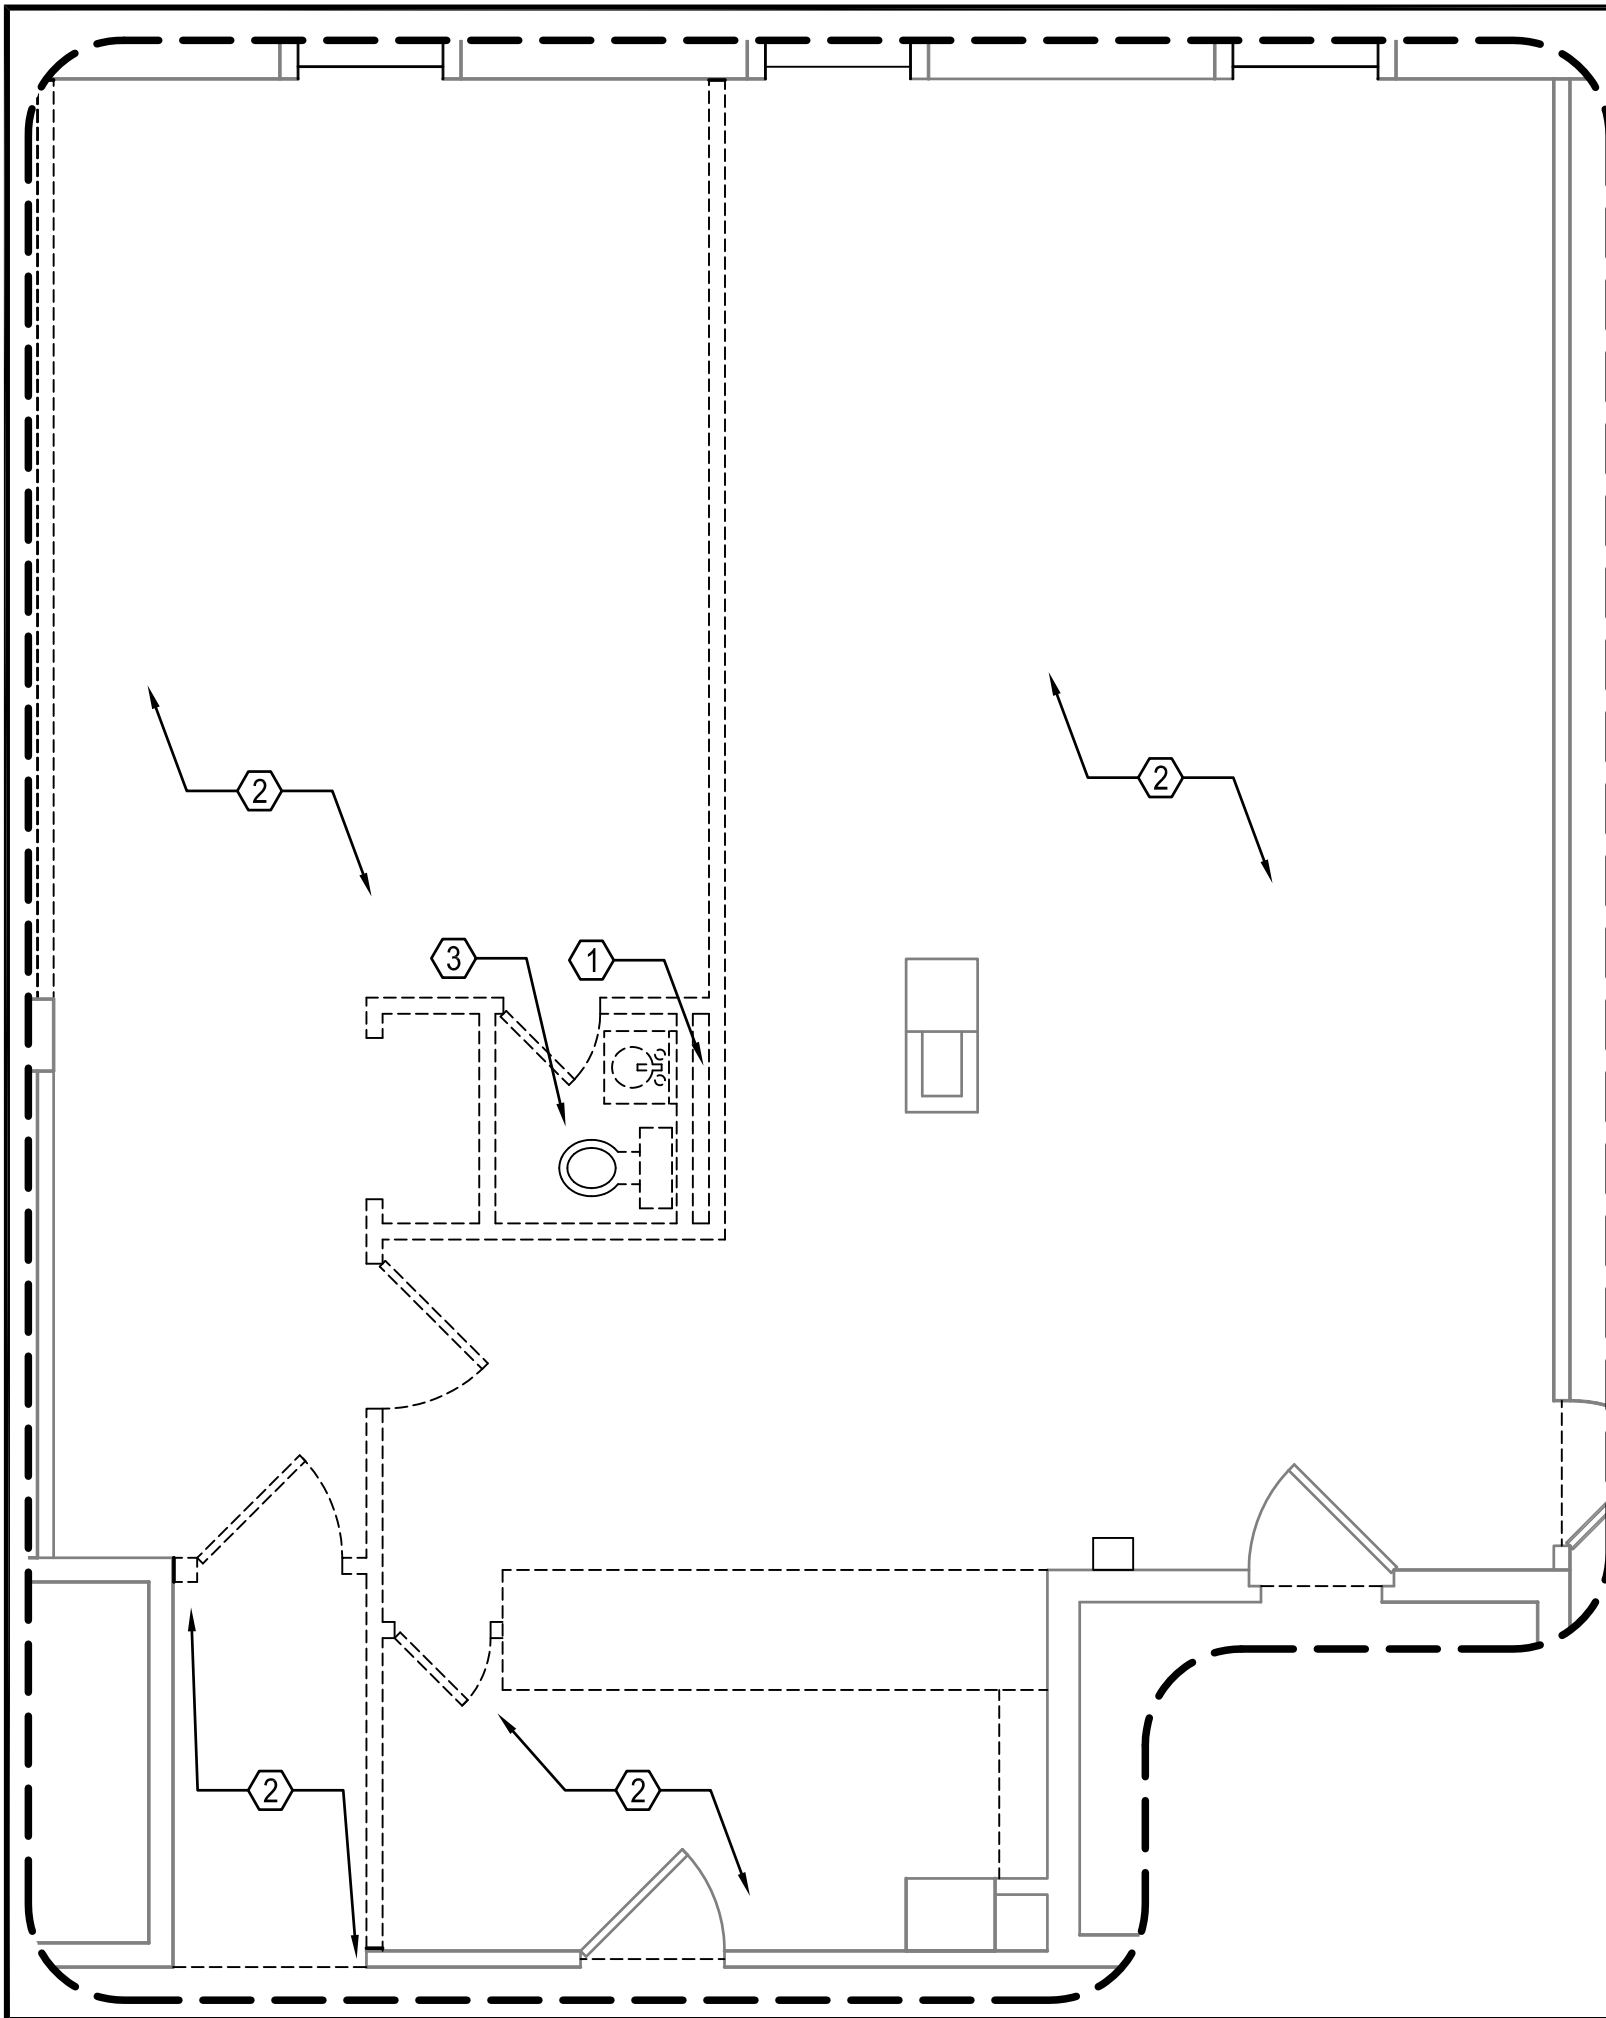

CATTARAUGUS COUNTY
COURT RENOVATIONS ON SECOND FLOOR
LITTLE VALLEY COUNTY CENTER

REVISED HAZARDOUS MATERIALS
ABATEMENT PARTIAL SECOND FLOOR PLAN

Proj. No.	3076-35
Date	29 JULY 2013
Ref. Dwg.	HMA100
No.	SD-HM01

GENERAL DRAWING NOTES:

- A. ALL WORK SHALL BE PERFORMED IN ACCORDANCE WITH THE PROJECT SPECIFICATION AND ALL FEDERAL, STATE AND LOCAL REGULATIONS INCLUDING BUT NOT LIMITED TO OSHA 29 CFR 1926, 40 CFR PART 763 AND PART 61 SUBPART M, NYS INDUSTRIAL CODE RULE 56 AND ALL APPROPRIATE APPLICABLE AND SPECIFIC VARIANCES.
- B. AREAS UNDER ABATEMENT SHALL BE PROPERLY POSTED WITH WARNING SIGNS AND SECURED TO PREVENT UNAUTHORIZED ENTRIES.
- C. THE LOCATION OF ANY ON-SITE STORAGE OF MATERIALS, EQUIPMENT DUMPSTER/WASTE TRAILER AND DECONTAMINATION FACILITIES SHALL BE COORDINATED WITH AND APPROVED BY THE OWNER'S REPRESENTATIVE AND ARCHITECT.
- D. THE OWNER HAS NOT APPLIED FOR A SITE SPECIFIC VARIANCE FOR THIS PROJECT. ANY VARIANCE APPLICATION PREPARED BY THE CONTRACTOR OR ITS AGENT MUST BE SUBMITTED TO THE OWNER FOR APPROVAL PRIOR TO SUBMISSION TO THE STATE OF NEW YORK DEPARTMENT OF LABOR ENGINEERING SERVICES FOR PROCESSING. THE OWNER SHALL BEAR NO ADDITIONAL COST AS A RESULT OF THE APPROVAL OF, THE DENIAL OF, AND/OR CONDITIONS SET FORTH WITHIN THE SITE SPECIFIC VARIANCE.
- E. CONTRACTOR SHALL REFER TO COMPLETE DRAWING SET FOR COORDINATION OF NOTES.

GENERAL NOTE TO ALL TRADES - ALL CONSTRUCTION ACTIVITIES INVOLVING POTENTIAL LEAD EXPOSURES MUST BE CONDUCTED IN COMPLIANCE WITH OSHA LEAD EXPOSURE IN CONSTRUCTION RULE (29 CFR 1926.62).

ASBESTOS REMOVAL NOTES:

- 1 REMOVE AND PROPERLY DISPOSE OF ASBESTOS CONTAINING MUD JOINT/FITTING INSULATION IN THE AREAS INDICATED. COORDINATE REMOVALS WITH PLUMBING DRAWINGS TO ACCOMMODATE EXISTING PLUMBING REMOVALS AND TIE-INS OF NEW PLUMBING. REMOVALS TO ACCOMMODATE PROPOSED TIE-INS MAY EXIST ABOVE FIRST FLOOR CEILING. ANY FITTINGS THAT REQUIRE ABATEMENT OUTSIDE THE AREA SHOWN ON THE DRAWING ARE THE RESPONSIBILITY OF THE ABATEMENT CONTRACTOR UNDER THIS CONTRACT. DEMOLITION OF WALLS AND CEILINGS REQUIRED TO ACCESS ASBESTOS CONTAINING MATERIALS SHALL BE CONDUCTED BY A LICENSED ASBESTOS ABATEMENT CONTRACTOR AS PER 12NYCRR56-7.11(f)(4). AREA CONTAINMENT MEASURES AND REMOVAL SHALL BE IN COMPLIANCE WITH 12NYCRR56.
- 2 REMOVE AND PROPERLY DISPOSE OF EXISTING FLOORING SYSTEM IN ITS ENTIRETY TO BARE CONCRETE SUBSTRATE. FLOOR TILE MASTIC IS AN ASBESTOS-CONTAINING MATERIAL. REMOVAL SHALL INCLUDE ALL CARPET AND UNDERLYING FLOOR TILE AND MASTIC, AS WELL AS ANY FLOORING MATERIALS BENEATH WALLS AND/OR MILLWORK THAT ARE SCHEDULED FOR DEMOLITION. SEE A100 FOR LOCATIONS OF TRANSITION STRIPS INDICATING TERMINATION OF REMOVAL. AREA CONTAINMENT MEASURES AND REMOVAL SHALL BE IN COMPLIANCE WITH 12NYCRR56.
- 3 REMOVE AND PROPERLY DISPOSE OF CERAMIC FLOOR TILE AND ASSOCIATED MUDSET AND GROUT IN ITS ENTIRETY. MUDSET AND GROUT OF CERAMIC FLOOR TILE HAVE BEEN ASSUMED TO BE ASBESTOS-CONTAINING MATERIALS. AREA CONTAINMENT MEASURES AND REMOVAL SHALL BE IN COMPLIANCE WITH 12NYCRR56.




CATTARAUGUS COUNTY
COURT RENOVATIONS ON SECOND FLOOR
LITTLE VALLEY COUNTY CENTER

REVISED HAZARDOUS MATERIALS
ABATEMENT PARTIAL SECOND FLOOR PLAN NOTES


Proj. No.	3076-35
Date	29 JULY 2013
Ref. Dwg.	HMA100
No.	SD-HM02

6. DISCONNECT AND REMOVE 3 GANGED WALL SWITCH, BOX AND COVER.
 7. DISCONNECT AND REMOVE 1X4 SURFACE MOUNTED LIGHTING FIXTURE.
 8. NEW YORK STATE CEILING MOUNTED WIRELESS ACCESS POINT. OWNER TO CONTACT STATE FOR REMOVAL AND REINSTALLATION OF THEIR EQUIPMENT.
- ADDENDUM No.1

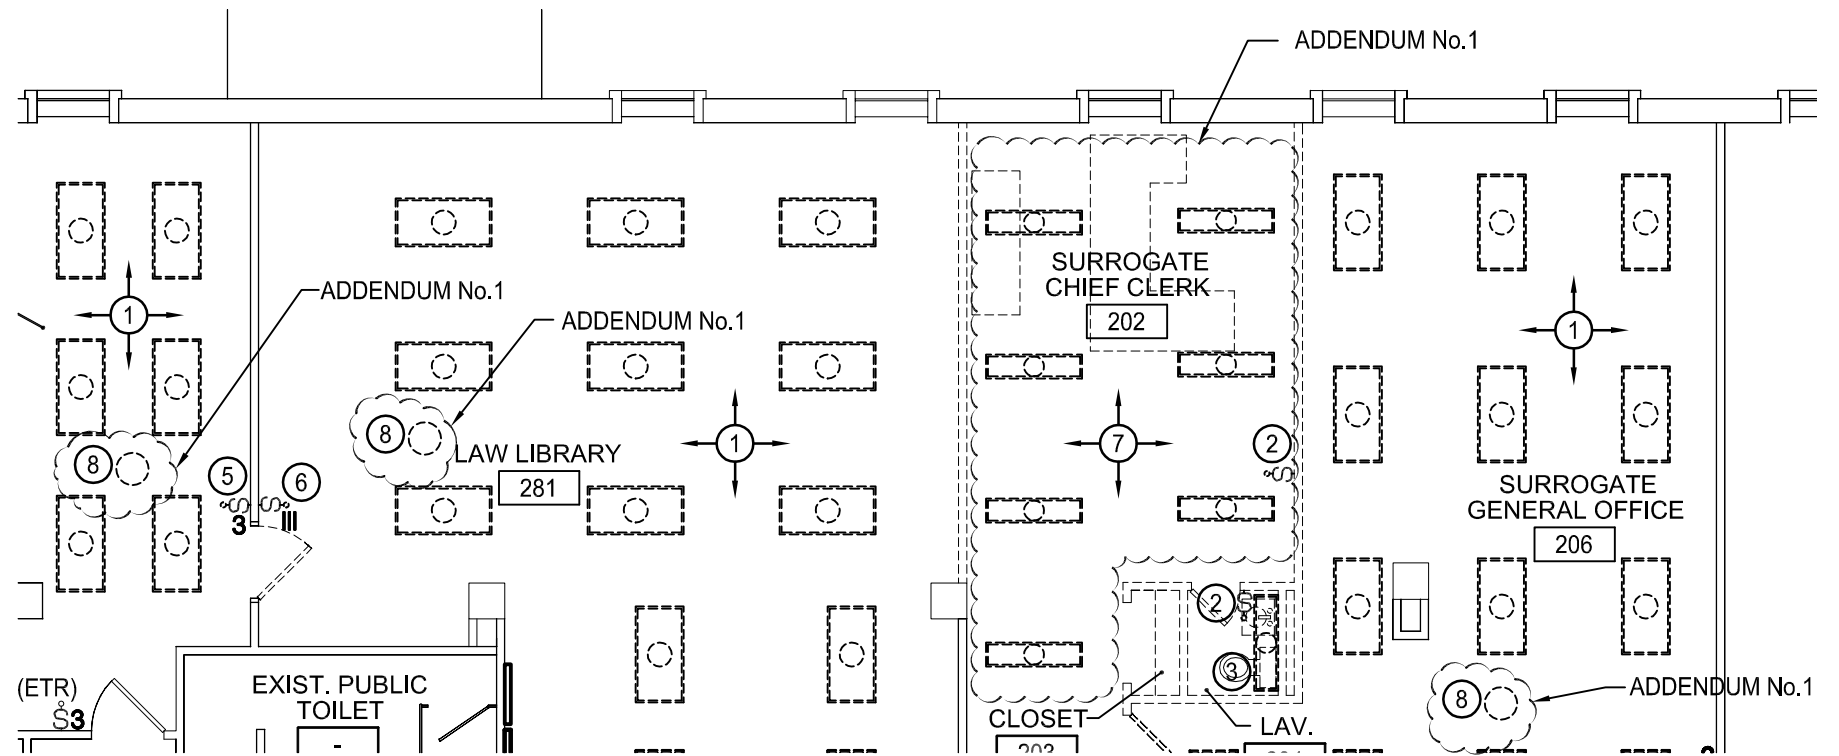

1 PARTIAL SECOND FLOOR LIGHTING - DEMOLITION

SCALE: 1/8" = 1'-0"

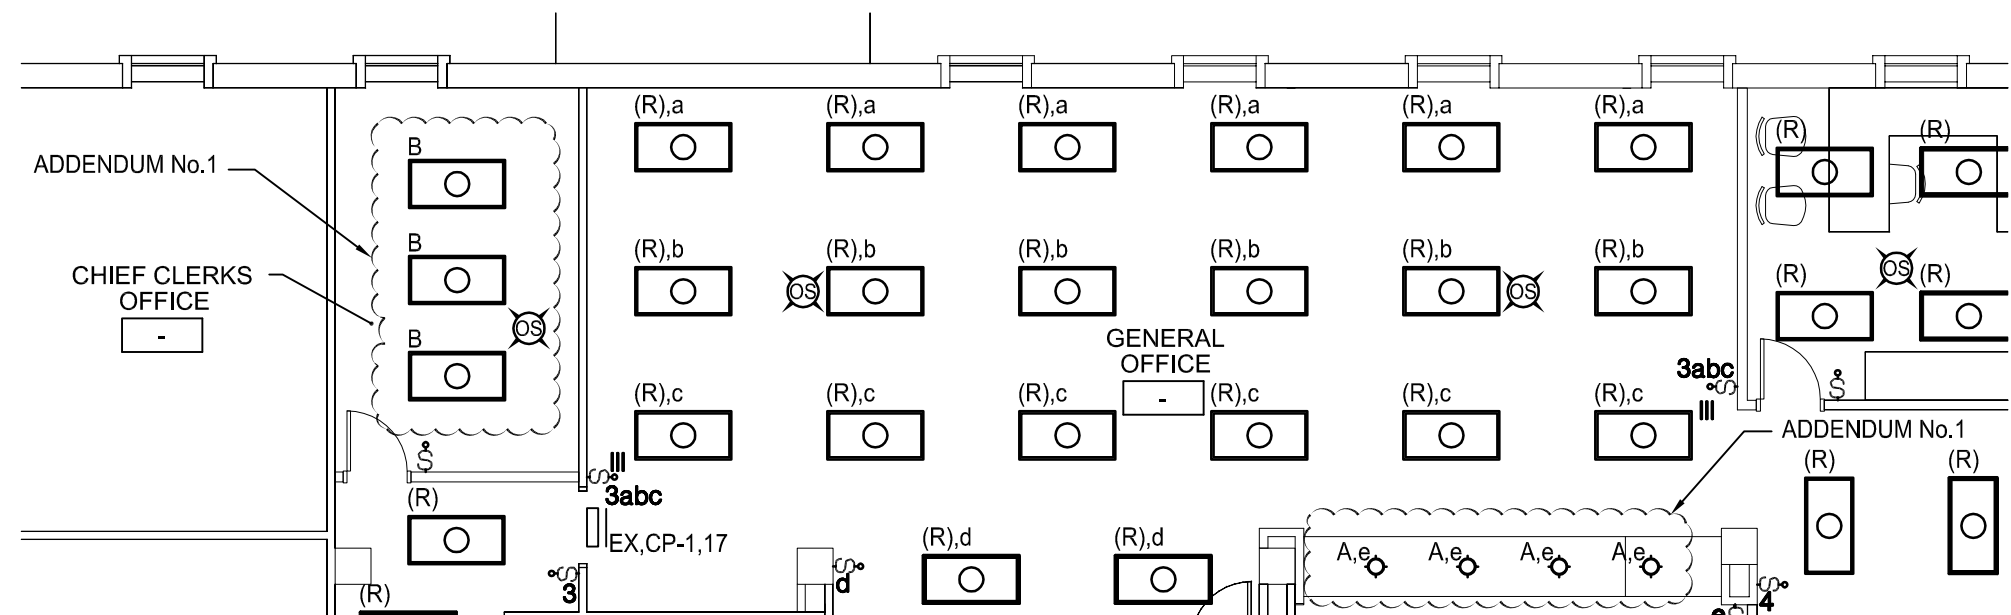

1 PARTIAL SECOND FLOOR LIGHTING - NEW WORK
SCALE: 1/8" = 1'-0"

LUMINAIRE SCHEDULE

TYPE	DESCRIPTION	LENS	BALLAST	LAMPS	BASIS OF DESIGN
A	ROUND RECESSED 8" DOWNLIGHT. SUITABLE FOR THROUGH WRING. FOR INSTALLATION IN GYPSUM WALL BOARD CEILING.	PRISMATIC	FOR USE ON 120 VOLT SYSTEM	(2) 26 WATT QUAD TUBE SUPPLIED WITH FIXTURE	PRESOLITE CFR626EB-ST372A-SS-CLEAR ALZAK-PL-LP
EX	ILLUMINATED "EXIT" SIGN. SHALL BE CONCEALED LED TYPE IN A HIGH IMPACT POLYCARBONATE OR THERMOPLASTIC HOUSING. DESIGNED & BUILT FOR AC/DC OPERATION. SELF-CONTAINED, MAINTENANCE FREE NICKEL CADMIUM BATTERY CONCEALED WITHIN HOUSING FOR EMERGENCY OPERATION. BATTERY SHALL BE SIZED FOR MINIMUM 90 MINUTES OF OPERATION. CLEAR POLYCARBONATE VANDAL SHIELD. UNIVERSAL MOUNTING CAPABILITY. UNIVERSAL CHEVRON STYLE KNOCKOUTS. REFER TO DRAWINGS FOR REQUIRED DIRECTIONS.	RED LETTERS WITH ARROWS AS SHOWN ON THE PLANS AND VANDAL SHIELD	LED DRIVER, 120V AC	LONG LIFE RED LED	DUAL-LITE - CV3 SERIES
B	2X4 RECESSED PARABOLIC LIGHTING FIXTURE. BLACK REVEAL WITH FULL ARC HANDLING CAPABILITIES.	PARABOLIC 3X6 18 CELL	FOR USE ON 120 VOLT SYSTEM	(3) T8 32 WATT	COLUMBIA LIGHTING CATALOG NO. P4D24-332G-LS-3X6-A-E-U

2 LUMINAIRE SCHEDULE
SCALE: N.T.S.



www.wendelcompanies.com

CATTARAUGUS COUNTY
COURT RENOVATIONS ON SECOND FLOOR
LITTLE VALLEY COUNTY CENTER

REVISED PARTIAL NEW WORK
LIGHTING PLAN


ADDENDUM No.1

Proj. No. 3076-35

Date 29 JULY 2013

Ref. Dwg. E101

No. SD-E02

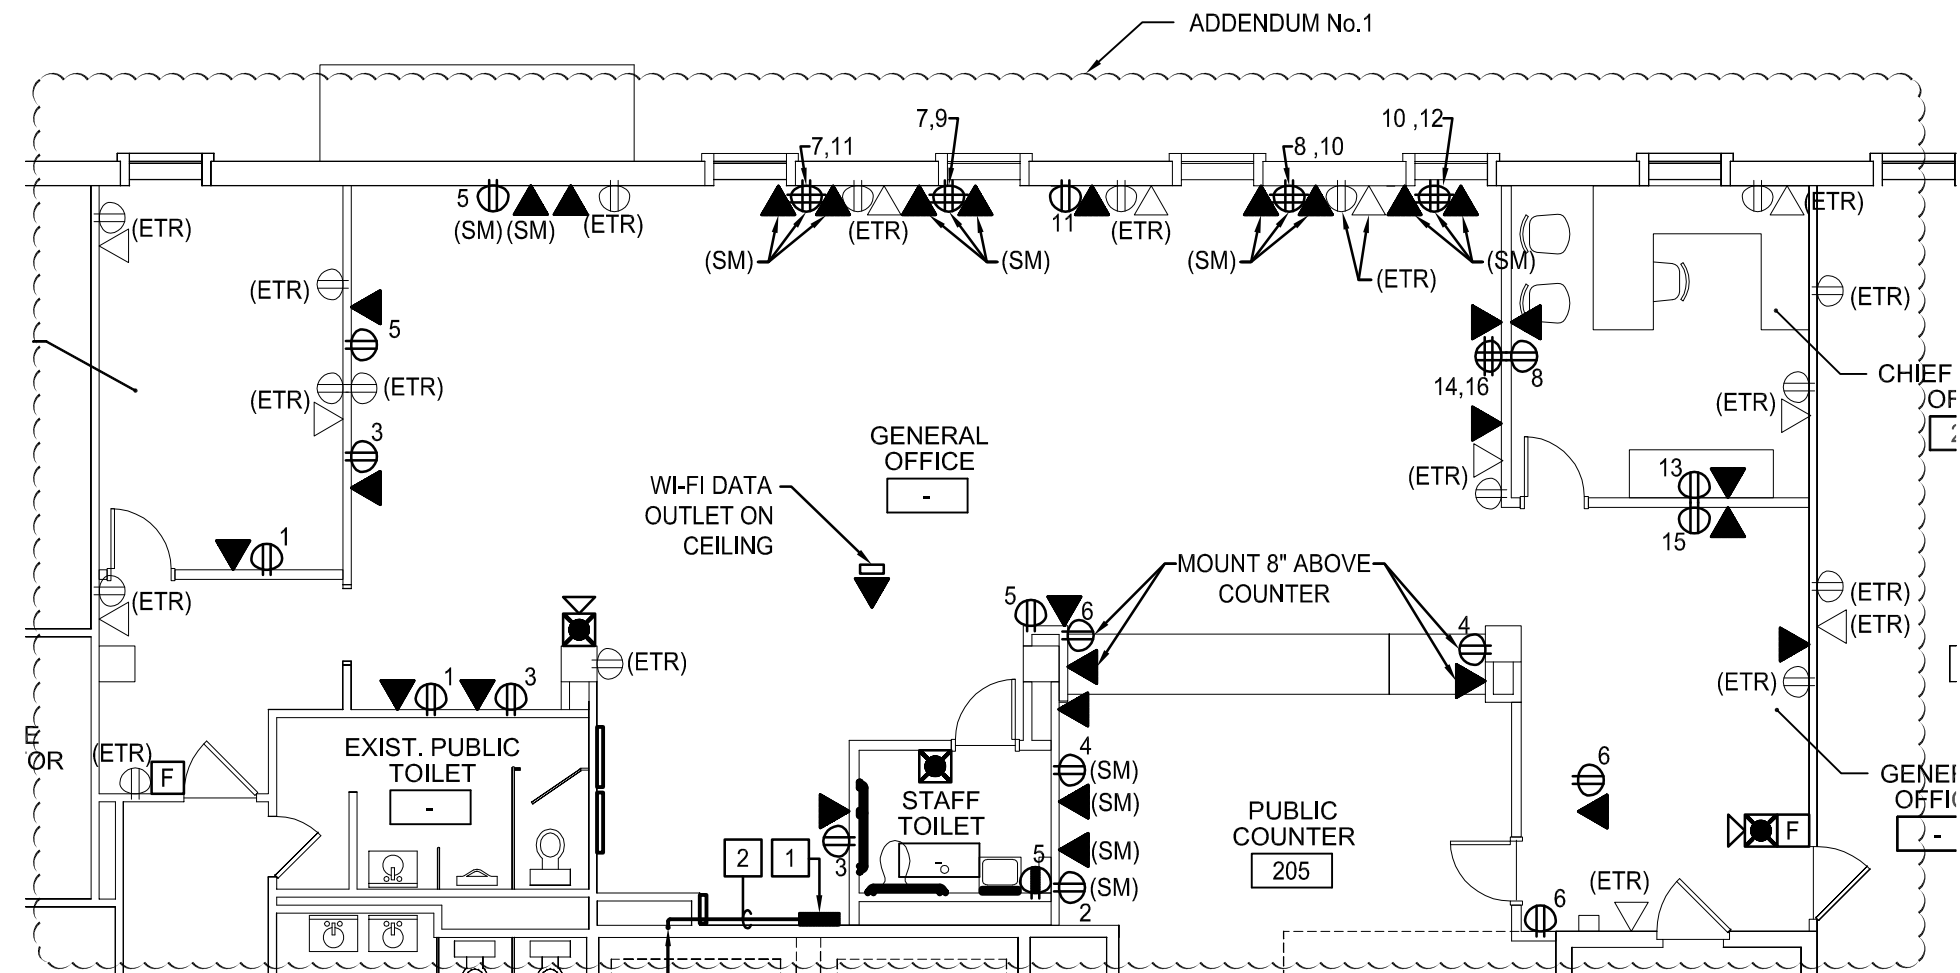

1 PARTIAL SECOND FLOOR POWER & SYSTEMS - NEW WORK
 SCALE: 1/8" = 1'-0"